



**AUSTIN HOME SYSTEMS**

*simplifying technology*

1102 W Koenig Ln  
Austin, TX 78756  
(512)293-3179

Newcastle Homes

2609 Park View Dr.  
Austin, TX 78757

Control **4**


Authorized  
**DIAMOND**  
Dealer 2020

**Preliminary**  
04/25/2023 8:09:48 AM

Markups By: Ken Medbery

Sheet:

Sheet Title:

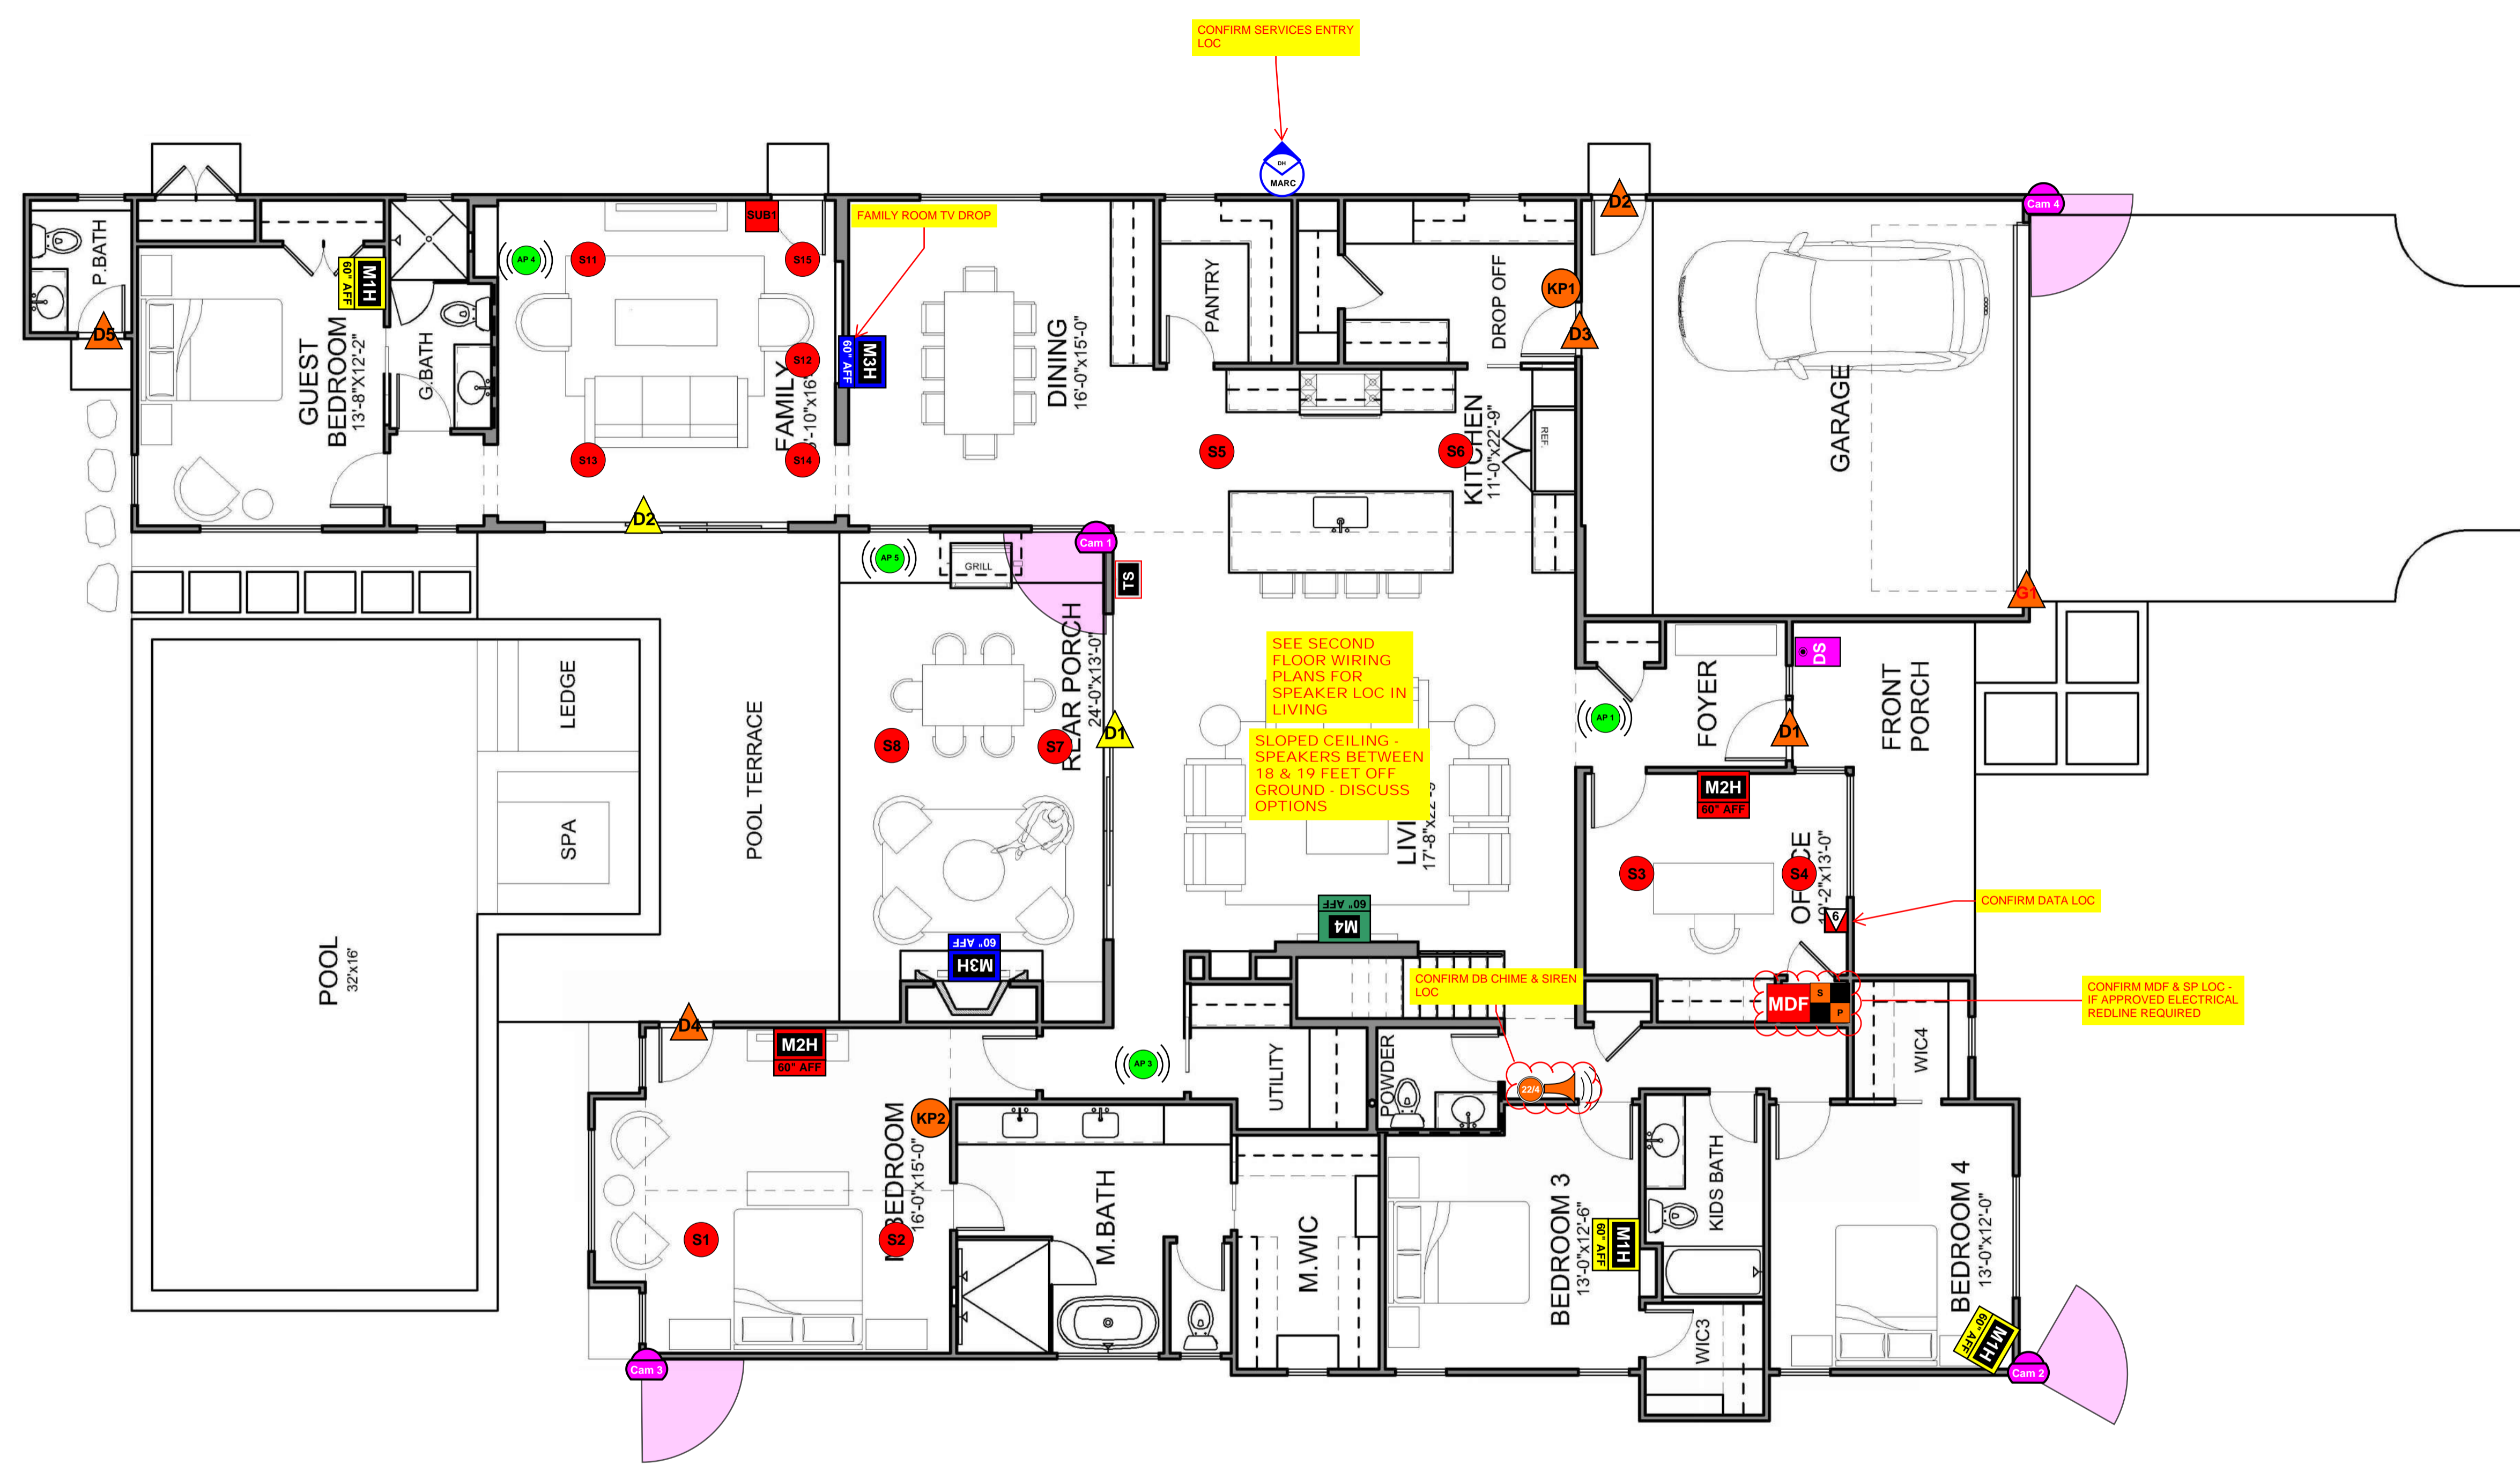

AUSTIN HOME SYSTEMS	
LOW VOLTAGE KEY	
Main Distribution Frame (Structural Wiring Panel) (1) 162, or 70V Drop	In-celling Speaker (1) 162, or 70V Drop
Intermediate Distribution Frame (Structural Wiring Panel) (1) 142	In-celling Stereo Speaker (1) 162
Demarcation Point (1) 162, or 70V Drop	In-celling Stereo Speaker w/ Bracket (1) 162
Demarcation Point (1) 162, or 70V Drop	In-celling Stereo Speaker w/ Bracket (1) 162
Pool/Landscape Sub-Out (2) CAT5e / (1) 164	In-wall Speaker (1) 162
Pool/Landscape Sub-Out (2) CAT5e / (1) 164	In-wall Speaker w/ Bracket (1) 162
Satellite Service (2) RG6	Surface Mounted Speaker (1) 162
Conduit (1) 162	Surface Mounted Stereo Speaker (1) 162
Conduit (2) 162	LCR Soundbar (1) 162
Single Data (1) Cat5e	Center Soundbar (1) 162
Dual Data (2) Cat5e	Landscape Speaker (1) 162, or 70V Drop
Tri Data (3) Cat5e	In-celling Speaker (1) 162
Quad Data (4) Cat5e	In-celling Speaker w/ Bracket (1) 162
Single Fiber (1) MM Fiber	In-wall Speaker (1) 142
Single Fiber (1) SM Fiber	In-wall Speaker w/ Bracket (1) 142
Wireless Access Point (1) Cat5e	In-wall Speaker (1) 142
In-celling Speaker (1) 162	In-celling Speaker (1) 162
In-celling Speaker (1) 162	In-celling Speaker (1) 162
THERMOSTAT	THERMOSTAT
FOUR-WAY SWITCH	CABLE TV OUTLET
DIMMER SWITCH	GARAGE DOOR OPERATOR
FAN SPEED CONTROL SWITCH	INTERNET
TIMER SWITCH	SMOKE DETECTOR
ONE GANG OF SWITCHES	CARBON MONOXIDE DETECTOR
STACK ONE GANG OF SWITCHES BELOW THE OTHER	GAS SUPPLY W/ SHUT OFF VALVE
GANG SWITCH-OUTLET COMBO (AT SINK VANITY)	HOSE BIBB (PROST-PROF)
DUPLEX RECEPTACLE (12" A.F.F. U.N.O.)	PUSH BUTTON CONTROL
DUPLEX RECEPTACLE MOUNTED AT X" A.F.F.	WATER SUPPLY
DUPLEX RECEPTACLE MOUNTED HORIZONTAL	SHUT-OFF VALVE
DUPLEX RECEPTACLE W WEATHER PROOF COVER	PANEL
SWITCHED OUTLET-SWITCH LOWER HALF	ELECTRICAL METER
QUAD RECEPTACLE (12" A.F.F. U.N.O.)	GAS METER
220V RECEPTACLE	
220V RECEPTACLE	
DUPLEX RECEPTACLE RECESSED INTO FLOOR	